

CH

CONTEXT

F

5921

CUTTING

W94

CO-ORDINATES:

East. 3.5

North. 4.3

DATE EXPOSED

29.7.84

DATE COMPLETED

DESCRIPTION

Sub-circular area of brown soil: P. h.

MAX. WIDTH AND DIRECTION

90cm N-S

MAX. LENGTH AND DIRECTION

1.10 E-W

MAX. DEPTH/HEIGHT THICKNESS

20cm

OVERLIES

OVERLAIN BY

1

CUTS

5904, bedrock

CUT BY

ABUTS OR CONTIGUOUS WITH

PLANS

No.

Sketch Plan B
Plan 1; TO BE PLANNED IN 1985

SECTIONS

No.

PHOTO: B/W

COL.

NEG. NOS.

SAMPLE Type:

Nos.

EXCAVATOR

S. Page

RECORDER

TC/KG

ASSOCIATED FEATURES

ASSOCIATED FINDS

COMMENT

~~Post-hole~~ 2. Probably not a feature 6.8.84

~~Natural~~, 8.8.84


No: it is a post-hole

See Section.

PHASING

Post-dates redolithic bank 5904.

SECTION:

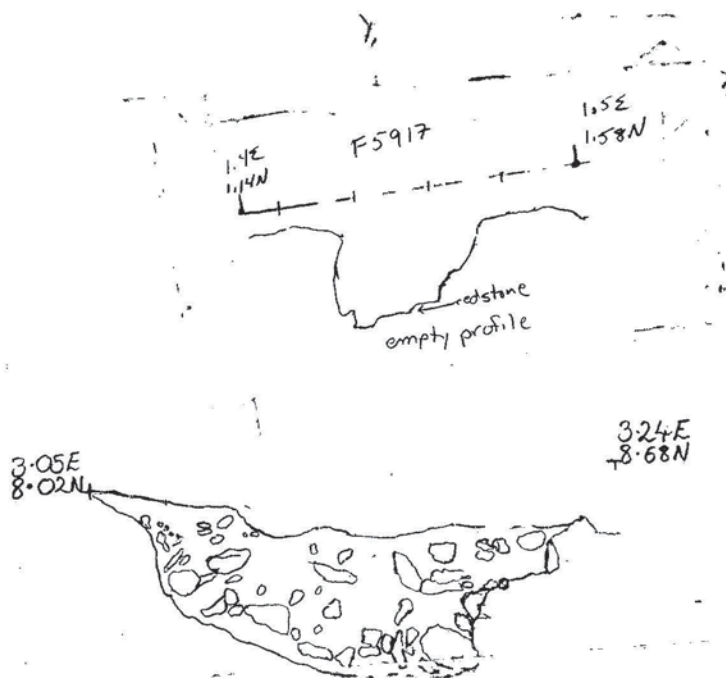

CH84
W94
1/2 Section
of F5921
1:10
Bryn Boreham
19.8.84

NO

Date: 30.07.84

Feature Nr: 5922. (Post hole)

Section: N-S (East facing). Excavated by J. A. Boreham

Finds: 1 piece charcoal: X
or half 3 fragments pottery: X

Site: CH84
Cutting W94

Scale: 1:10

E8.88
N5.28

E8.80
N4.58

Datum line 0 10 20 30 40 50 60 70



Layer ① Brown soil, mainly small stones
Layer ② yellowish/brown soil, larger stones more tightly packed